


REGISTERED SURVEYOR'S CERTIFICATION  
I, GRAHAM LINDSAY, hereby certify that the levels  
shown on this plan are a true and correct record and were located by survey.

LandPartners Limited, Reg. Surveyor No. S2309 Date: 17/01/2017

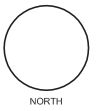

NORTH

REVISIONS

| No | Description  | Date     | By |
|----|--------------|----------|----|
| A  | FOR APPROVAL | 19/01/16 |    |
|    |              |          |    |
|    |              |          |    |
AS CONSTRUCTED DETAILS

I CERTIFY THAT THE 'AS CONSTRUCTED' DETAILS  
SHOWN ON THIS PLAN ARE TRUE AND ACCURATE  
RECORD OF THE WORKS.

SIGNED:   
NAME OF SIGNATORY (PRINT): WILLIE MALHERBE  
RPEQ NO: 8112  
COMPANY NAME: ACOR CONSULTANTS (QLD) PTY LTD



**KARAMISHEFF  
NAGEL PTY LTD**  
CONSULTING ENGINEERS

71 GREY STREET  
SOUTH BRISBANE QLD 4101

PO BOX 3059  
SOUTH BRISBANE BC 4101

TEL: (07) 3844 5744  
FAX: (07) 3844 5788  
EMAIL: admin@knagel.com.au  
WEB: www.knagel.com.au

ABN 93 114 479 524

Approved - Disclosed RPEQ 2009

ASSOCIATED CONSULTANTS:

**LANDPARTNERS**  
BUILT ENVIRONMENT CONSULTANTS

CLIENT:  
**RESIDEV QLD PTY LTD**

PROJECT:  
**PROPOSED SUBDIVISION  
BASSETTS LANE, ROSEWOOD  
STAGE 5**

TITLE:  
**SEWER LONGITUDINAL  
SECTIONS - SHEET 1**

Local Authority  
**IPSWICH CITY COUNCIL**

|             |                |                |                 |
|-------------|----------------|----------------|-----------------|
| Drawn<br>PN | Designed<br>DW | Checked<br>GBN | Date<br>AUG '15 |
|-------------|----------------|----------------|-----------------|

|                   |             |          |
|-------------------|-------------|----------|
| Scale<br>AS SHOWN | Sheet<br>A3 | of<br>24 |
|-------------------|-------------|----------|

|                                |                      |
|--------------------------------|----------------------|
| Drawing No<br><b>15-106-24</b> | Revision<br><b>A</b> |
|--------------------------------|----------------------|

MAINTENANCE HOLE/SHAFT NO.

MH/MS COVER TYPE  
MH/MS TYPE  
MH/MS DROP TYPE  
BRANCH DROP TYPE  
BRANCH LINE NO.  
PROP. CONNECTION TYPE

PIPE NOMINAL DIA. (DN) TYPE, CLASS  
GRADE (1 IN X)  
LENGTH  
EMBEDMENT TYPE

Datum R.L.30.000


|                           |
|---------------------------|
| MANHOLE<br>DEPTH (m)      |
| INVERT LEVEL              |
| FINISHED<br>SURFACE LEVEL |
| NATURAL<br>SURFACE LEVEL  |
| CHAINAGE (CH)             |

SCALE A (Horiz.) 1:2000  
B (Vert.) 1:200

DO NOT SCALE THIS DRAWING. IF IN DOUBT ASK!

LINE 1


SCALE A 1:2000  
(Horiz.)

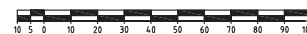

B 1:200  
(Vert.)



LEGEND

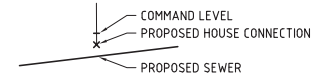

Ⓑ CLASS B NON-TRAFFICABLE COVER

Ⓓ CLASS D TRAFFICABLE COVER

REGISTERED SURVEYOR'S CERTIFICATION  
I, GRAHAM LINDSAY, hereby certify that the levels  
shown on this plan are a true and correct record and were located by survey.

Signed: [Signature]  
LandPartners Limited, Reg. Surveyor No. S2309 Date: 17/01/2017

(CH 339.214)

LINE 2  
(CH 228.586)

LINE 3  
(CH 104.497)

LINE 4  
(CH 104.497)

LINE 5  
(CH 104.497)

LINE 6  
(CH 104.497)

LINE 7  
(CH 104.497)

LINE 8  
(CH 104.497)

LINE 9  
(CH 104.497)

LINE 10  
(CH 104.497)

LINE 11  
(CH 104.497)

LINE 12  
(CH 104.497)

LINE 13  
(CH 104.497)

LINE 14  
(CH 104.497)

LINE 15  
(CH 104.497)

LINE 16  
(CH 104.497)

LINE 17  
(CH 104.497)

LINE 18  
(CH 104.497)

LINE 19  
(CH 104.497)

LINE 20  
(CH 104.497)

LINE 21  
(CH 104.497)

LINE 22  
(CH 104.497)

LINE 23  
(CH 104.497)

LINE 24  
(CH 104.497)

LINE 25  
(CH 104.497)

LINE 26  
(CH 104.497)

LINE 27  
(CH 104.497)

LINE 28  
(CH 104.497)

LINE 29  
(CH 104.497)

LINE 30  
(CH 104.497)

LINE 31  
(CH 104.497)

LINE 32  
(CH 104.497)

LINE 33  
(CH 104.497)

LINE 34  
(CH 104.497)

LINE 35  
(CH 104.497)

LINE 36  
(CH 104.497)

LINE 37  
(CH 104.497)

LINE 38  
(CH 104.497)

LINE 39  
(CH 104.497)

LINE 40  
(CH 104.497)

LINE 41  
(CH 104.497)

LINE 42  
(CH 104.497)

LINE 43  
(CH 104.497)

LINE 44  
(CH 104.497)

LINE 45  
(CH 104.497)

LINE 46  
(CH 104.497)

LINE 47  
(CH 104.497)

LINE 48  
(CH 104.497)

LINE 49  
(CH 104.497)

LINE 50  
(CH 104.497)

LINE 51  
(CH 104.497)

LINE 52  
(CH 104.497)

LINE 53  
(CH 104.497)

LINE 54  
(CH 104.497)

LINE 55  
