PSM197132
E: 460792.282
N: 6942289.236
RL: 41.911m

0 5 10 15 20 25m
SCALE 1:250 @A1

AS CONSTRUCTED

NOTES:
HORIZONTAL COORDINATES(E,N) SUPPLIED ARE MAPPING GRID OF AUSTRALIA(MGA), ZONE 56 BASED ON THE UNIVERSAL TRANSVERSE MERCATOR PROJECTION AND THE GEOCENTRIC DATUM OF AUSTRALIA 1994.
HORIZONTAL DATUM DERIVED FROM PSM197132 E:460792.282 N: 6942289.236.
LEVELS SUPPLIED ARE ON THE AUSTRALIAN HEIGHT DATUM(AHD)
LEVEL DATUM DERIVED FROM PSM197132 RL41.911 (AHD)

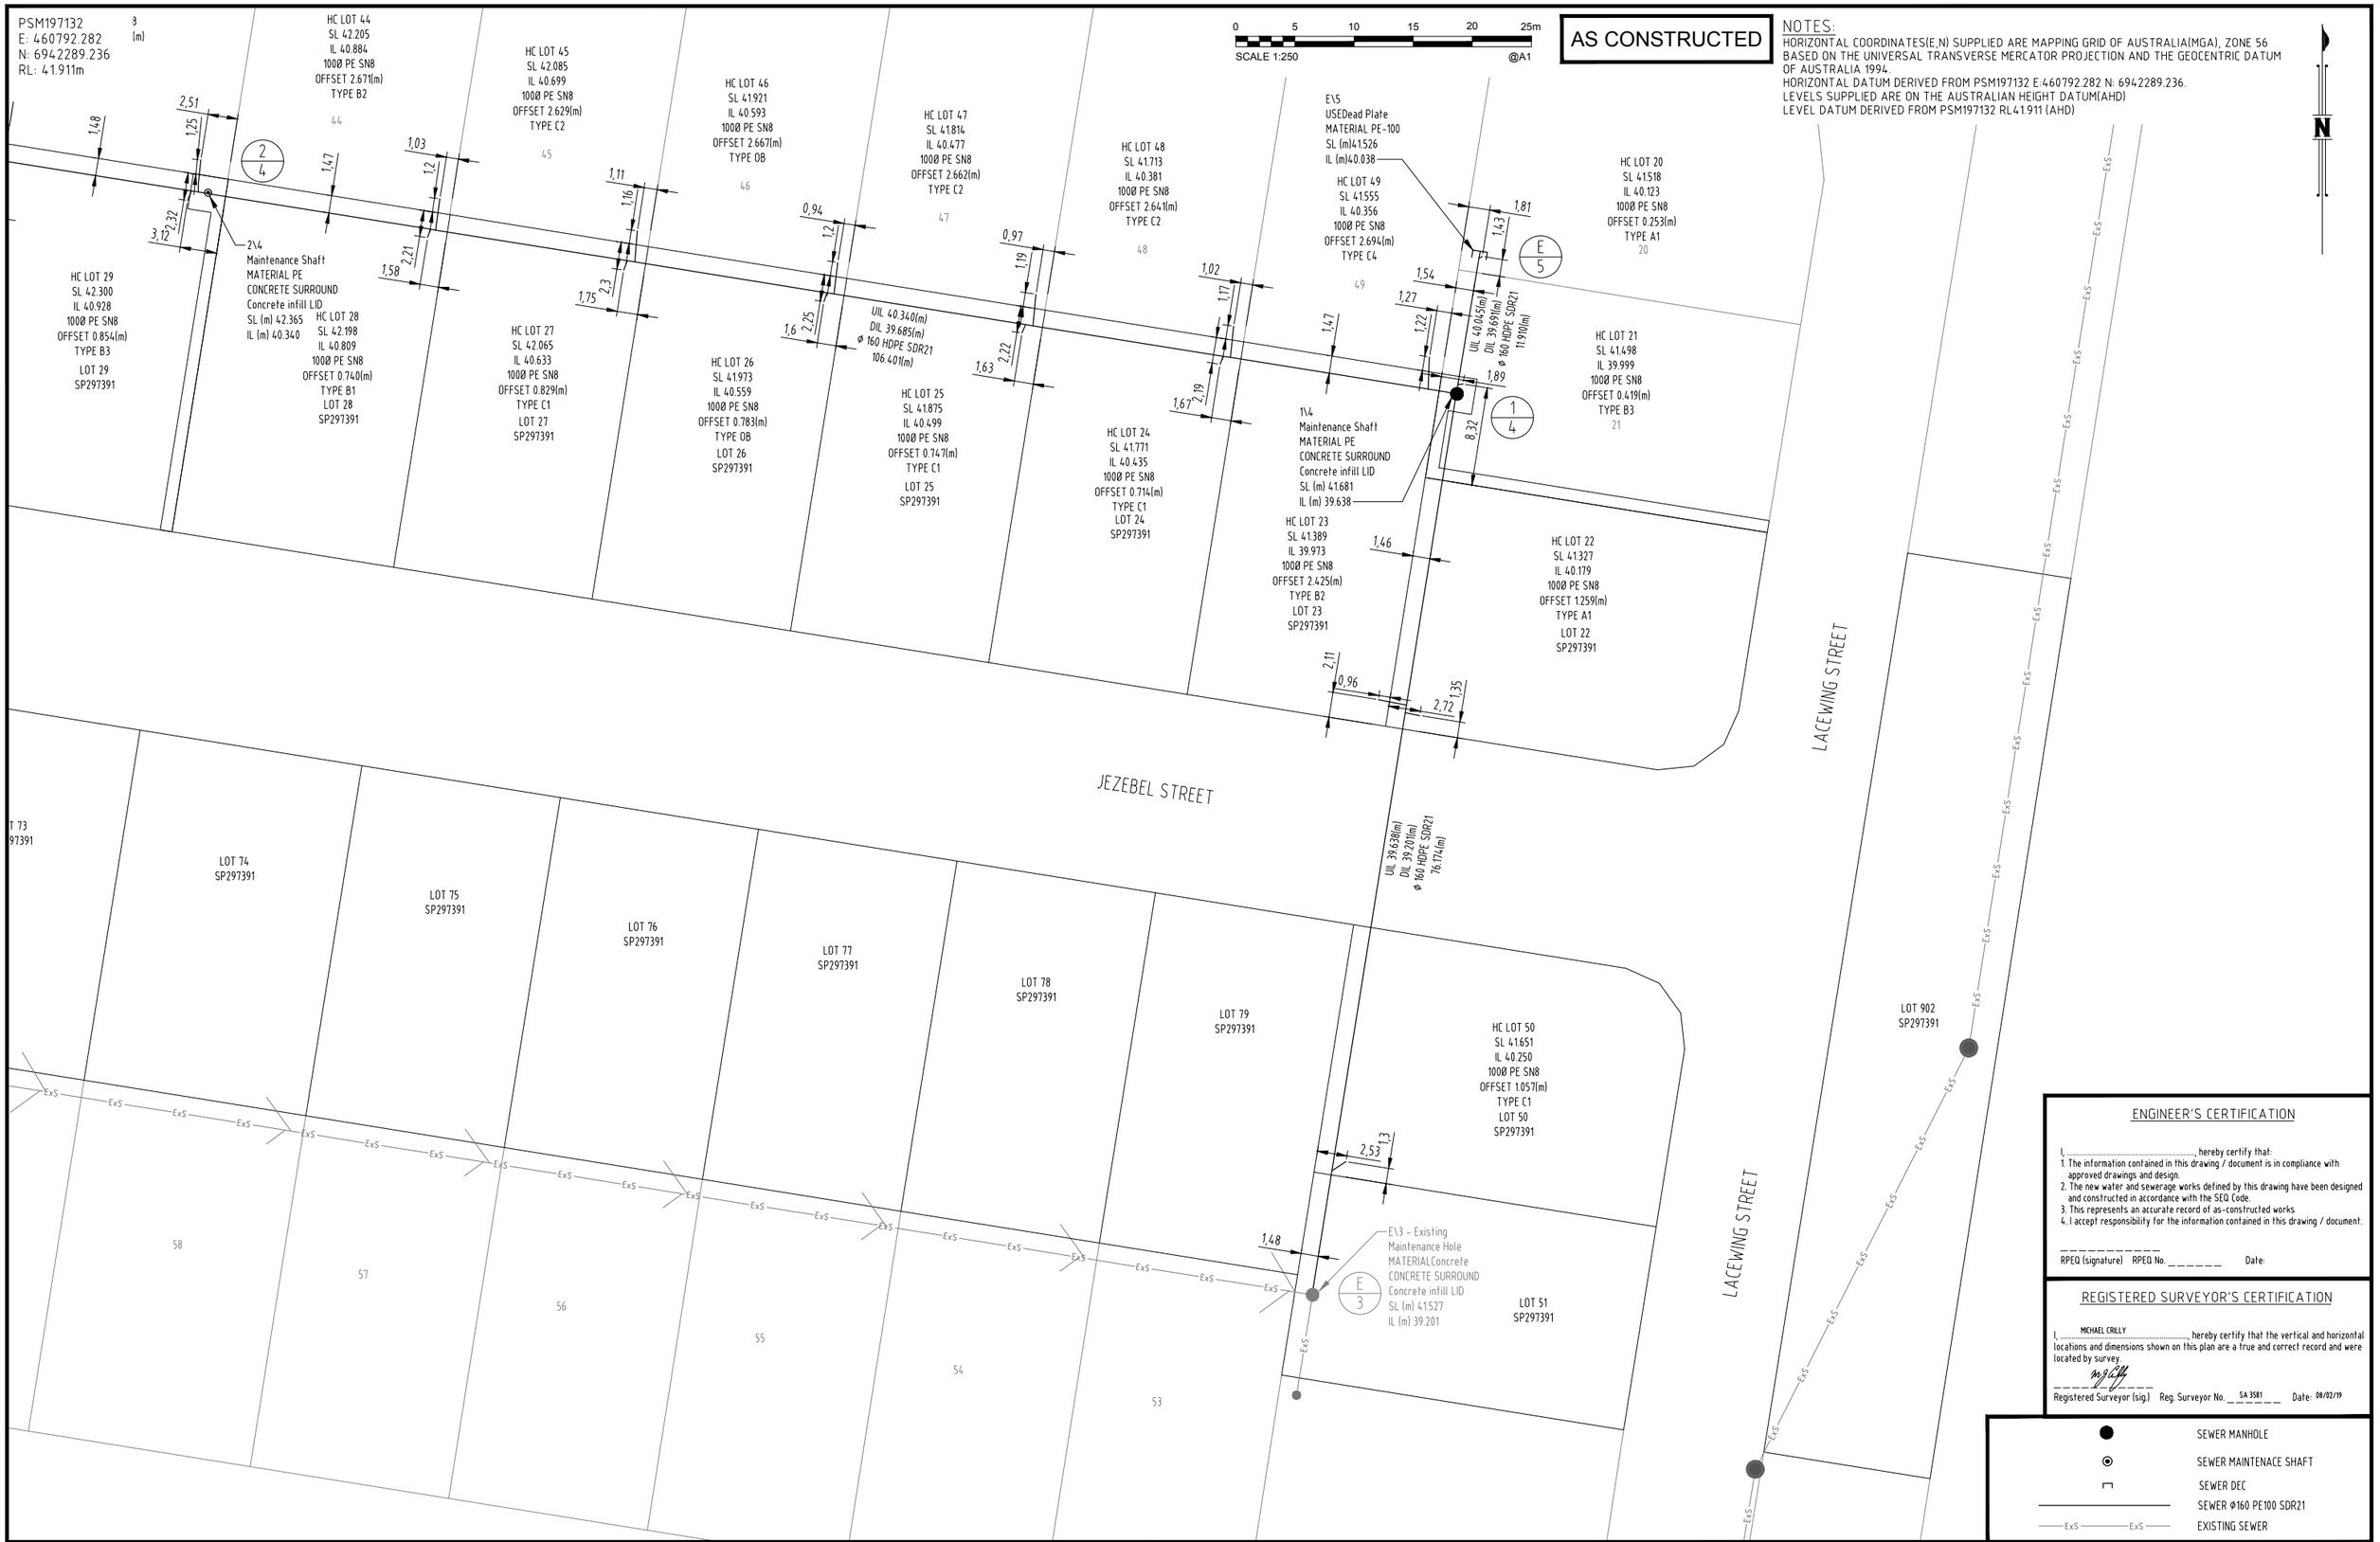

ENGINEER'S CERTIFICATION

I, ..., hereby certify that:
1. The information contained in this drawing / document is in compliance with approved drawings and design.
2. The new water and sewerage works defined by this drawing have been designed and constructed in accordance with the SEQ Code.
3. This represents an accurate record of as-constructed works
4. I accept responsibility for the information contained in this drawing / document.

_ _ _ _ _ _ _ _ _ _ _ _
RPEQ (signature) RPEQ No. _ _ _ _ _ _ Date:

REGISTERED SURVEYOR'S CERTIFICATION

I, MICHAEL CRILLY, hereby certify that the vertical and horizontal locations and dimensions shown on this plan are a true and correct record and were located by survey.

_ _ _ _ _ _ _ _ _ _ _ _
Registered Surveyor (sig.) Reg. Surveyor No. SA 3581 Date: 08/02/19

●	SEWER MANHOLE
⊙	SEWER MAINTENACE SHAFT
⊓	SEWER DEC
———	SEWER Ø160 PE100 SDR21
—ExS—ExS—	EXISTING SEWER

A1

INDEX	DATE	REVISIONS	DRAWN	CHECKED	PASSED
B	04/03/2019	SEWER HC INVERT LEVELS AMENDED	PJB	CT	CT
A	05/02/2019	AS CONSTRUCTED	DAM		

	INITIALS	DATE
DRAWN	DAM	08/02/19
CHECKED		
PASSED		

QUEENSLAND UrbanUtilities

Queensland Urban Utilities

QUU REF NO. 16-PNT-24121
AS CONSTRUCTED SURVEY - SEWER
ROSEHAVEN STAGE 7&8
QLD

SHEET 4 OF 4 SHEETS		SCALE 1:250
REVISION DATE	04/03/2019	REVISION B
DISCIPLINE CODE	–	
DRAWING NO. QUU-16-PNT-24121-S4		